


SET #	CL OF BATTEN	DESCRIPTION	ELEV. DWG	NOTES
TH	-6'-0"	THRUST STAGE EDGE	NA	STAGE EXTENSION
1	-0'-9"	MAIN BORDER	NA	LINESHAFT HOIST #1
PL	0'-0"	PLASTER LINE/STAGE EDGE	NA	
2	1'-0"	MASKING BORDER (NIC)	NA	ADC 140 WALK ALONG DUAL TRACK
3	1'-6"	MASKING CURTAINS (NIC)	NA	ADC 140 WALK ALONG DUAL TRACK
4	2'-2"	PROJECTION SCREEN	NA	EXISTING
5	3'-0"	FIRST ELECTRIC	R-2.0	LINESHAFT HOIST #2
6	3'-10"	#1 LEG	R-2.3	TIED TO BATTEN
7	4'-6"	#1 BORDER	NA	LINESHAFT HOIST #3
8	7'-6"	SECOND ELECTRIC	R-2.0	LINESHAFT HOIST #4
9	8'-6"	#2 LEG	R-2.4	TIED TO BATTEN
10	9'-0"	#2 BORDER	NA	LINESHAFT HOIST #5
11	11'-10"	THIRD ELECTRIC	R-2.0	LINESHAFT HOIST #6
12	12'-10"	#3 LEG	R-2.5	TIED TO BATTEN
13	13'-8"	#3 BORDER	NA	LINESHAFT HOIST #7
14	16'-10"	FOURTH ELECTRIC	R-2.0	LINESHAFT HOIST #8
15	18'-1"	#4 LEG	R-2.6	TIED TO BATTEN
16	18'-6"	#4 BORDER	NA	LINESHAFT HOIST #9
17	19'-4"	CYC ELECTRIC	R-2.1	LINESHAFT HOIST #10
18	20'-9"	SCENERY TRACK	NA	HEAVY DUTY WALK ALONG TRACK
19	21'-6"	REAR TRAVELER (NIC)	NA	ADC 2800 ROPE DRAWN BIPART TRACK
20	22'-6"	CYC HOIST	R-2.2	LINESHAFT HOIST #11
21	23'-8"	PROJECTION SCREEN	NA	ON ADC 2800 WALK ALONG TRACK

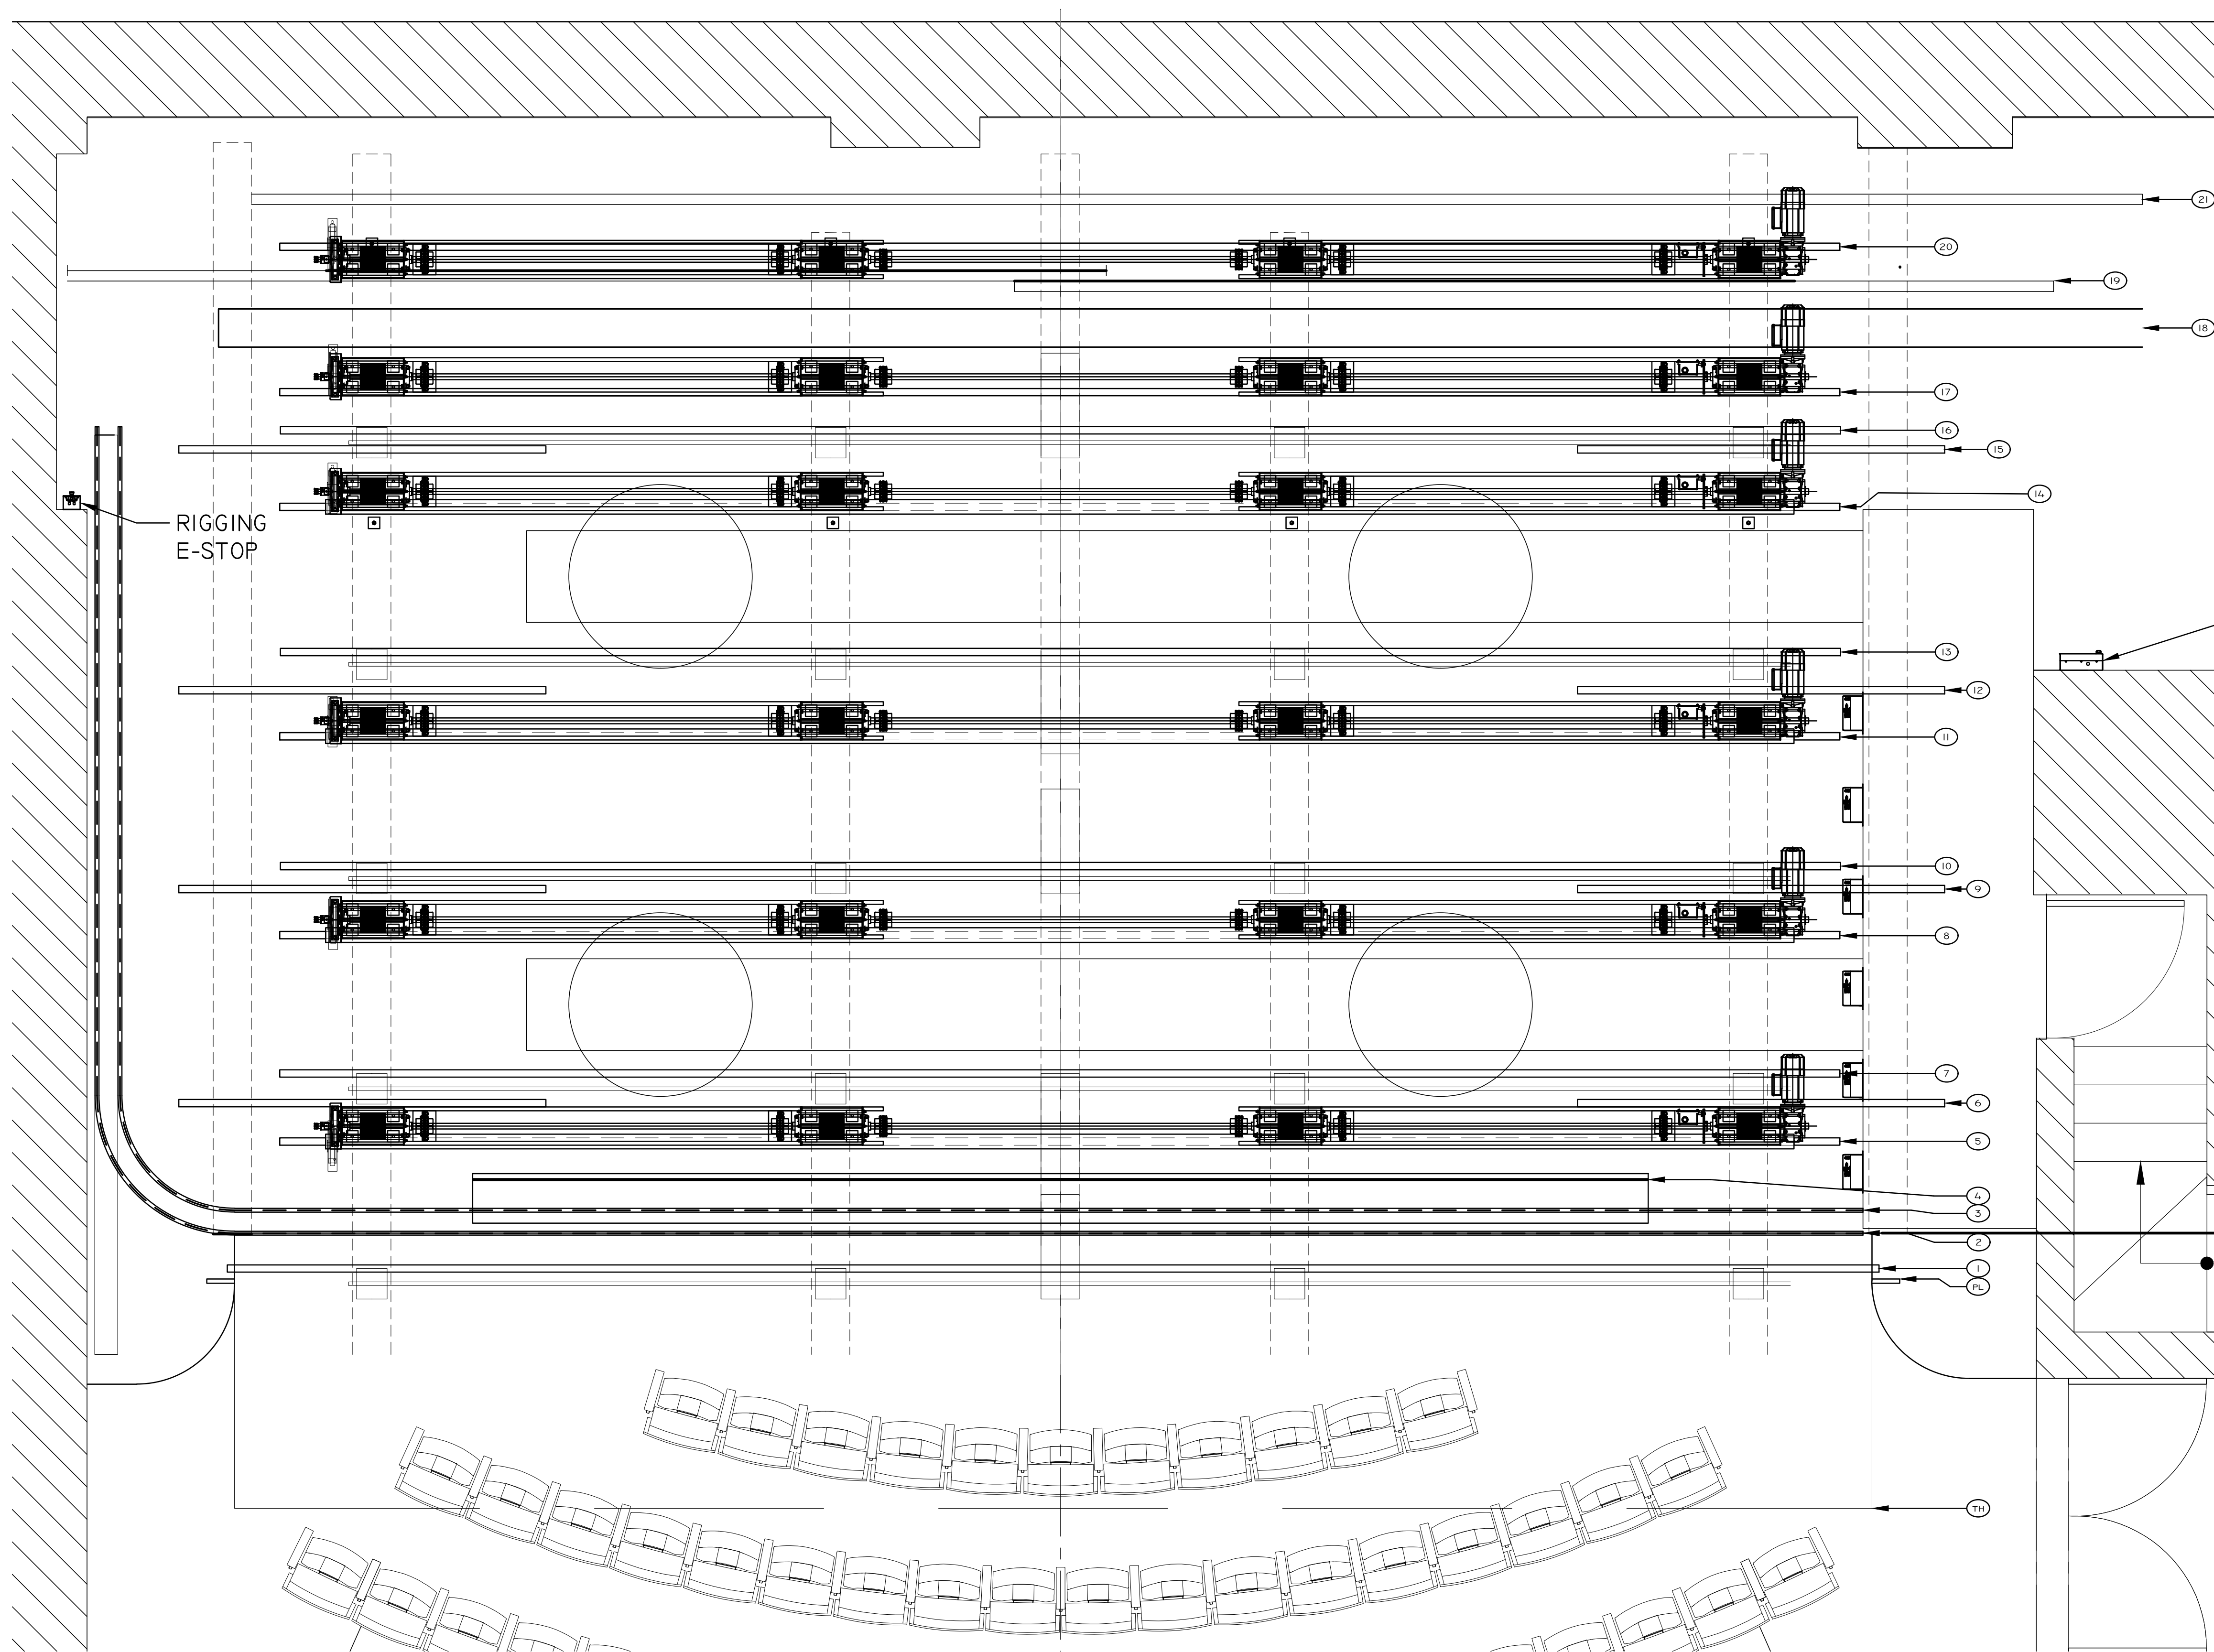

1 STAGE PLAN
R-1.0 SCALE: 1/2" = 1'-0"

SOFT GOOD DESCRIPTION	QUANTITY	HEIGHT	WIDTH	FABRIC TYPE	COLOR	FULLNESS	NOTES	LINESSET#
REAR TRAVELER LEGS	2	18'-10"	17'-0"	2042 CRESCENT IFR VELOUR	BLACK	FLAT	SNAPS	19
BORDER	8	19'-0"	6'-0"	2042 CRESCENT IFR VELOUR	BLACK	FLAT	TIES / CHAIN WEIGHT / PIPE POCKET	6,9,12,15
MASKING LEGS	4	4'-0"	34'-0"	2042 CRESCENT IFR VELOUR	BLACK	FLAT	GROMMETS AND TIES 1/2" D/C	7,10,13,16
MASKING BORDER	2	18'-4"	12'-0"	2042 CRESCENT IFR VELOUR	BLACK	FLAT	GROMMETS SNAPS	3
MAIN BORDER	1	4'-0"	35'-6"	2042 CRESCENT IFR VELOUR	BLACK	FLAT	SNAPS/PIPE POCKET/VELCRO SEAL	2
STAGE SKIRT	1	4'-0"	36'-0"	2042 CRESCENT IFR VELOUR	BLACK	FLAT	HIDDEN TIES / PIPE POCKET / VELCRO SEAL	1
STAGE SKIRT	1	2'-8"	36'-2"	2042 CRESCENT IFR VELOUR	BLACK	50%	LOOP VELOUR	NA

DRAPERY SCHEDULE

PROJECT: FRENCH INSTITUTE FLORENCE GOULD HALL 55 EAST 59TH STREET, NEW YORK, NY 10022		Pook Diemont & OHL, Inc. 701 EAST 132ND STREET BRONX, NEW YORK 10454 718-402-2677 718-402-2859 FAX	
DWG. TITLE: STAGE PLAN		ARCHITECT:	
MANUFACTURER:		CONSULTANT:	
SCALE: AS NOTED		GENERAL CONTRACTOR:	
DRAWN BY: MS	DATE: 5/25/16	JOB NUMBER: 35-0422	DRAWING NUMBER:

REV.	DATE	DESCRIPTION
9/12/2016	AS BUILT	
6/1/2016	SUBMITTAL	

